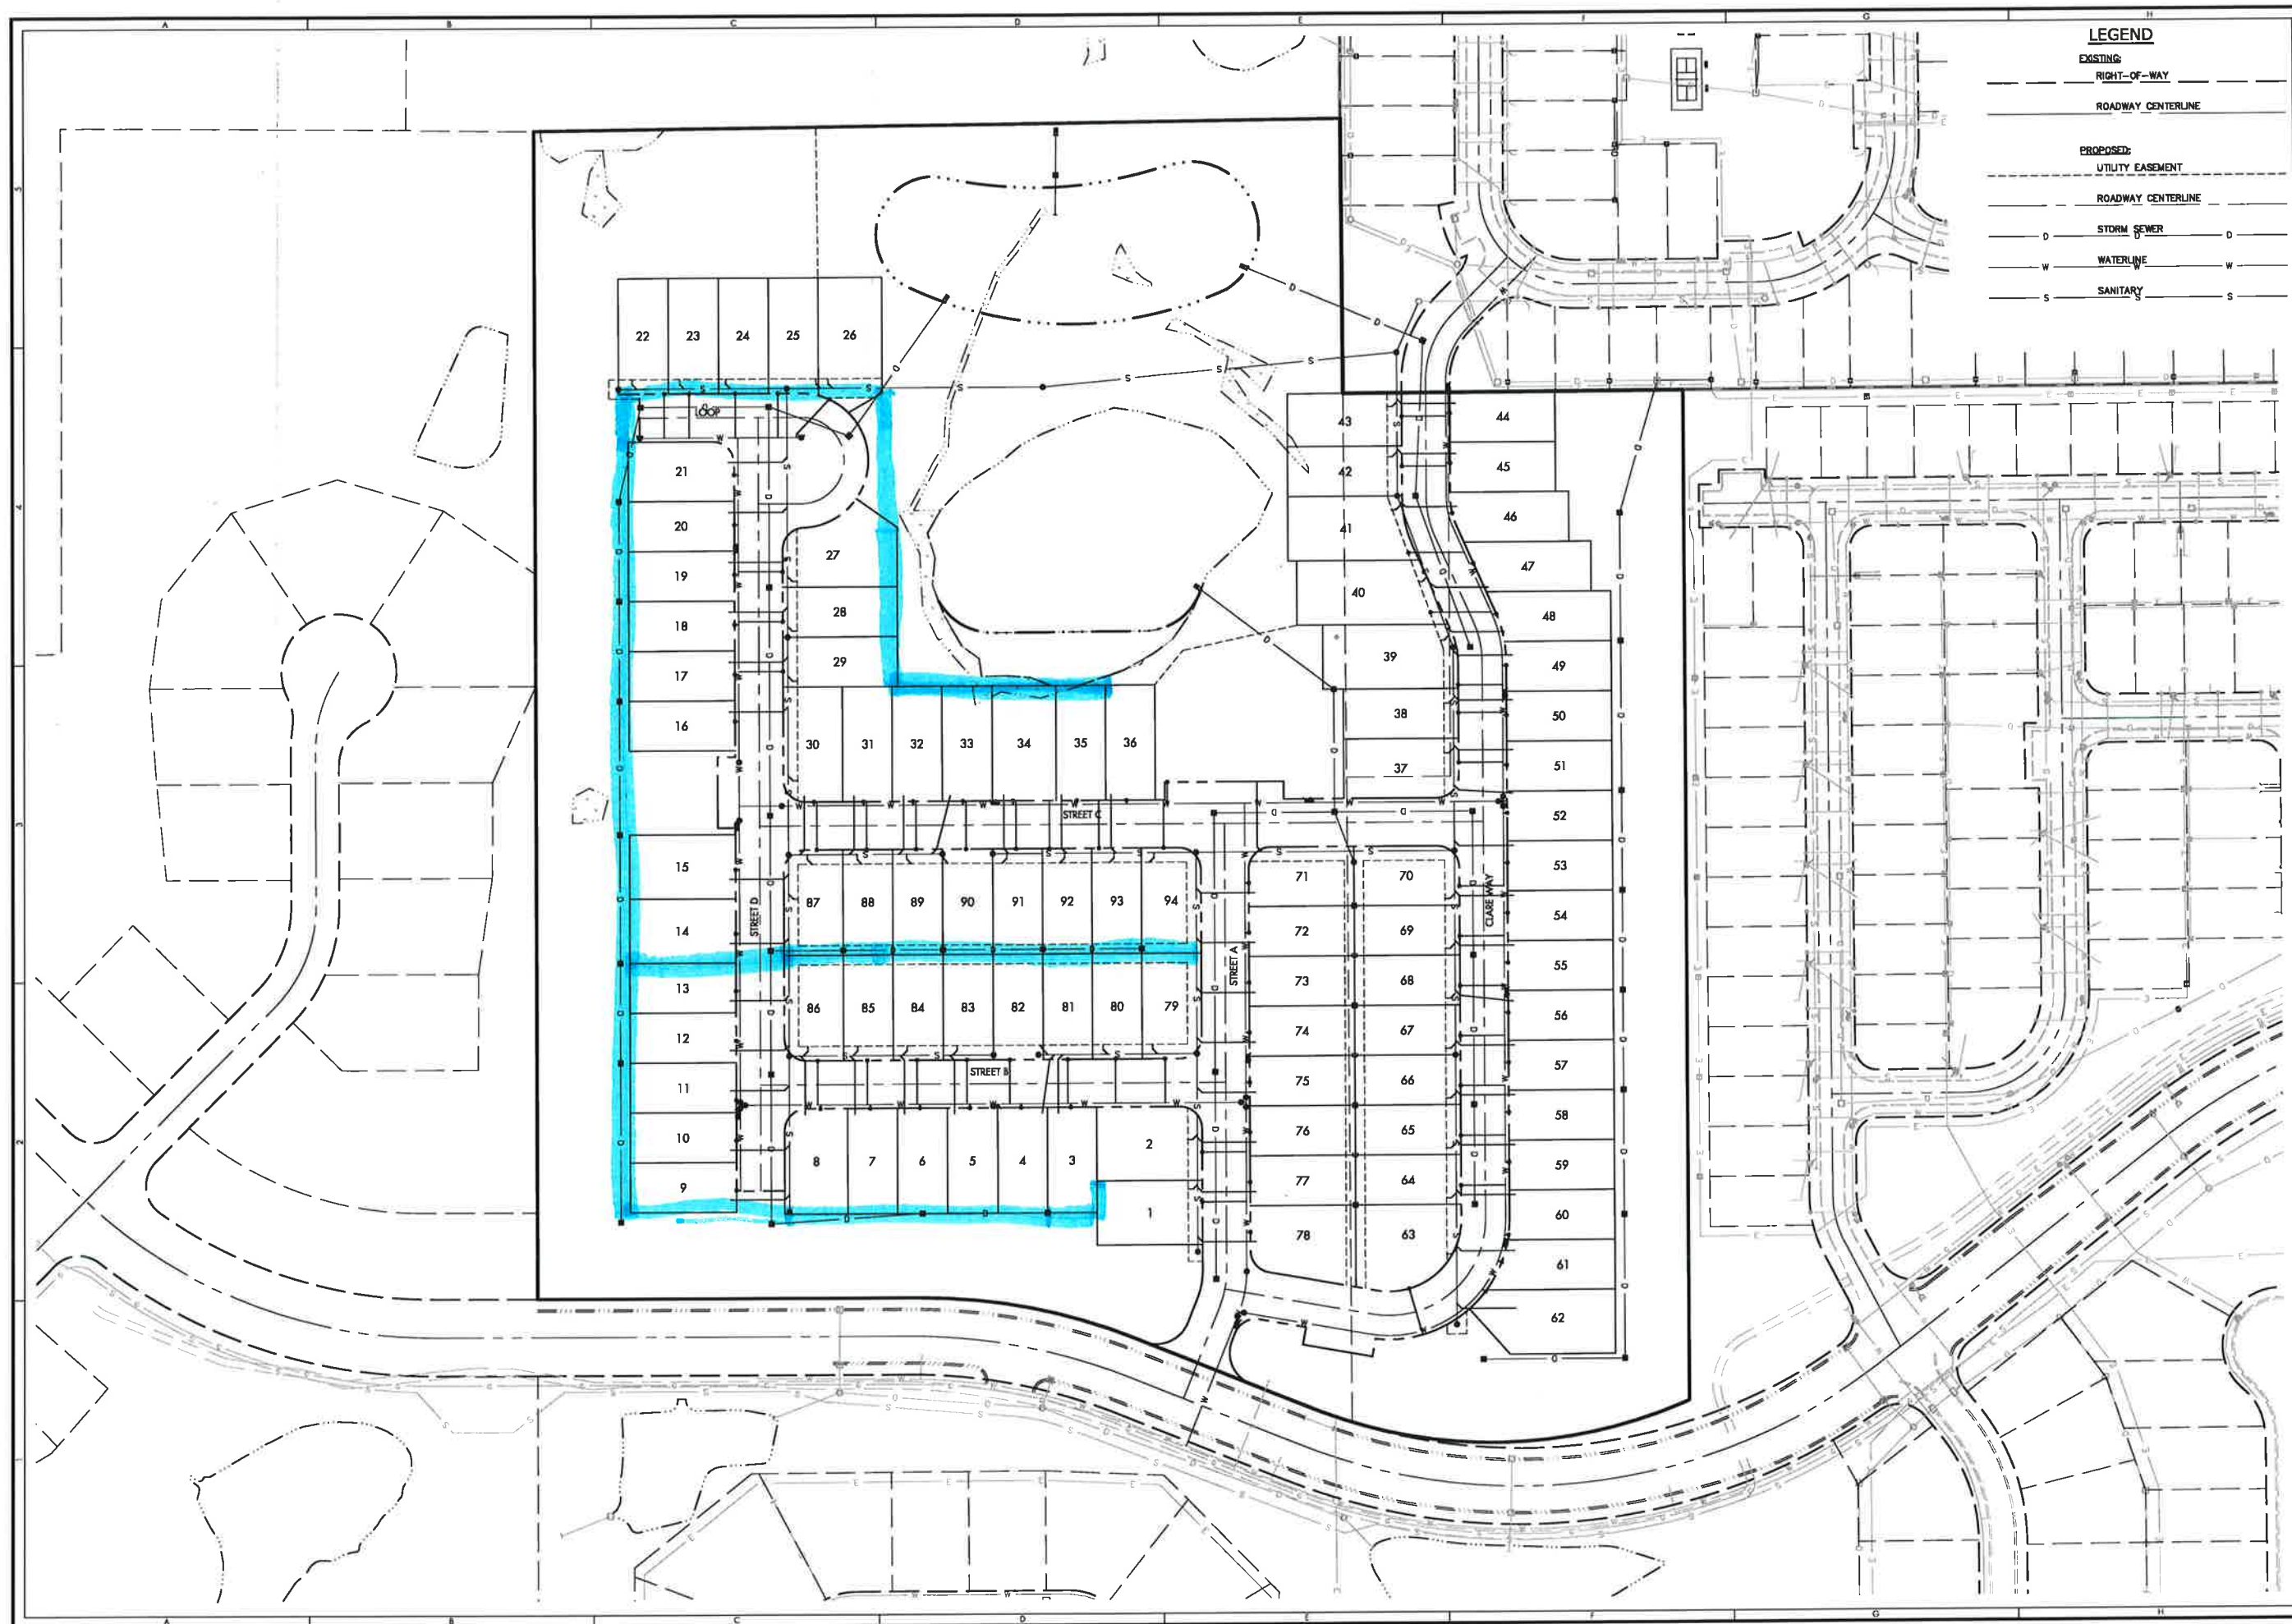


[illegible]

TerrainEvolution

Your bridge between Vision and Success

720 East Broad Street | Suite 203 | Columbus, OH 43215
P: 614.385.1090 | F: 614.385.1085 | E: info@terrainevolution.com

2

JEROME TOWNSHIP, UNION COUNTY, OHIO

THE COURTYARDS AT RYAN PARKWAY

COMPOSITE UTILITY PLAN

DRAWING SET STATUS:

☐ PRELIMINARY ENGINEERING SET
☐ AGENCY REVIEW SET
☐ CONSTRUCTION DOCUMENT SET
☐ AS-BUILT DOCUMENT SET

DESIGN	DRAFT	CHECK
DGR	DGR	JPW

PROJECT NO.: 22-035

DATE: JULY, 2023

SCALE:

HORIZONTAL:	1" = 80'
VERTICAL:	1" = 5'

SHEET NO.: 6/19